



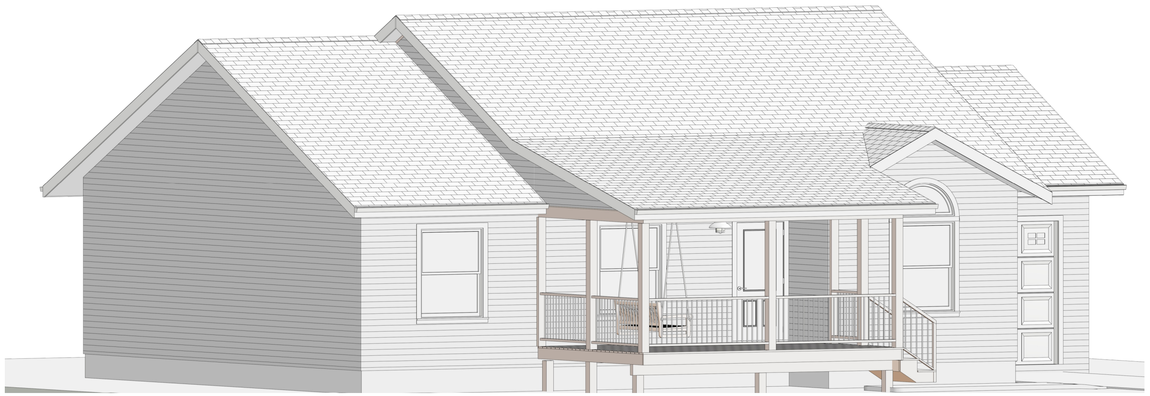

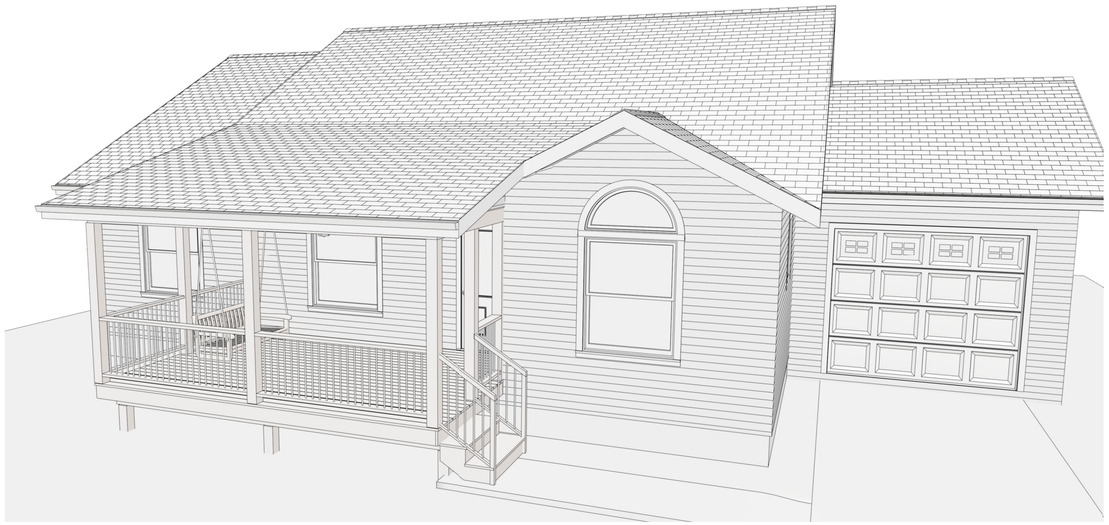

Left Side Exterior Elevation


NOTES:
-New Porch Roof Pitch 3:12
+/- for tie in to existing roof

-Extending existing porch; ceiling heights based on existing porch measurements

-Flat finished ceiling.



Front Exterior Elevation

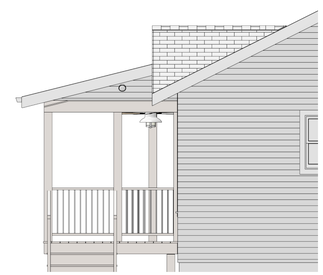

Right Side Exterior Elevation

DRAWINGS PROVIDED BY:
Semper Fi
Tamara Stillwell
Designer
tamara.stillwell@sfcustomremodeling.com


Max & Brooke Cherry
15 Avena St.
Black Mountain, NC 28711

Exterior Perspectives & Elevations

DATE:
5/29/2025


SCALE:
1/4"= 1'

SHEET:
1

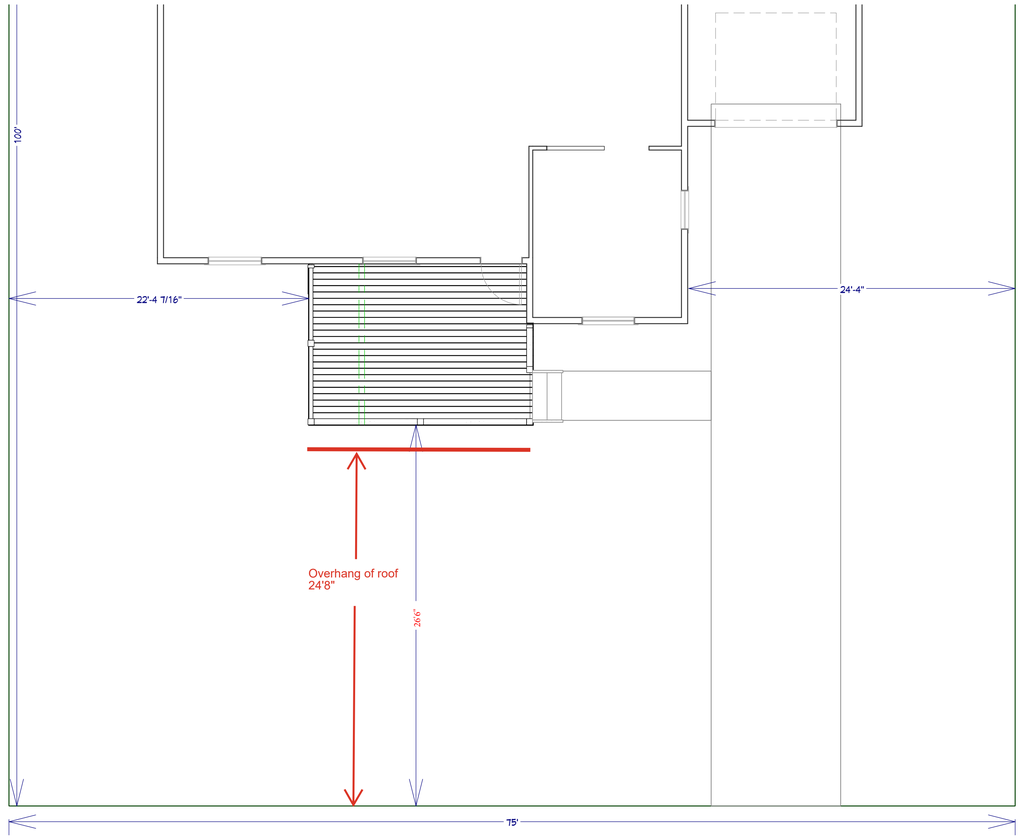

Property Line Dimensions -New Front Porch

Edge of deck band 26'6" and
Edge of roog overhang 24'8"
from right of way.

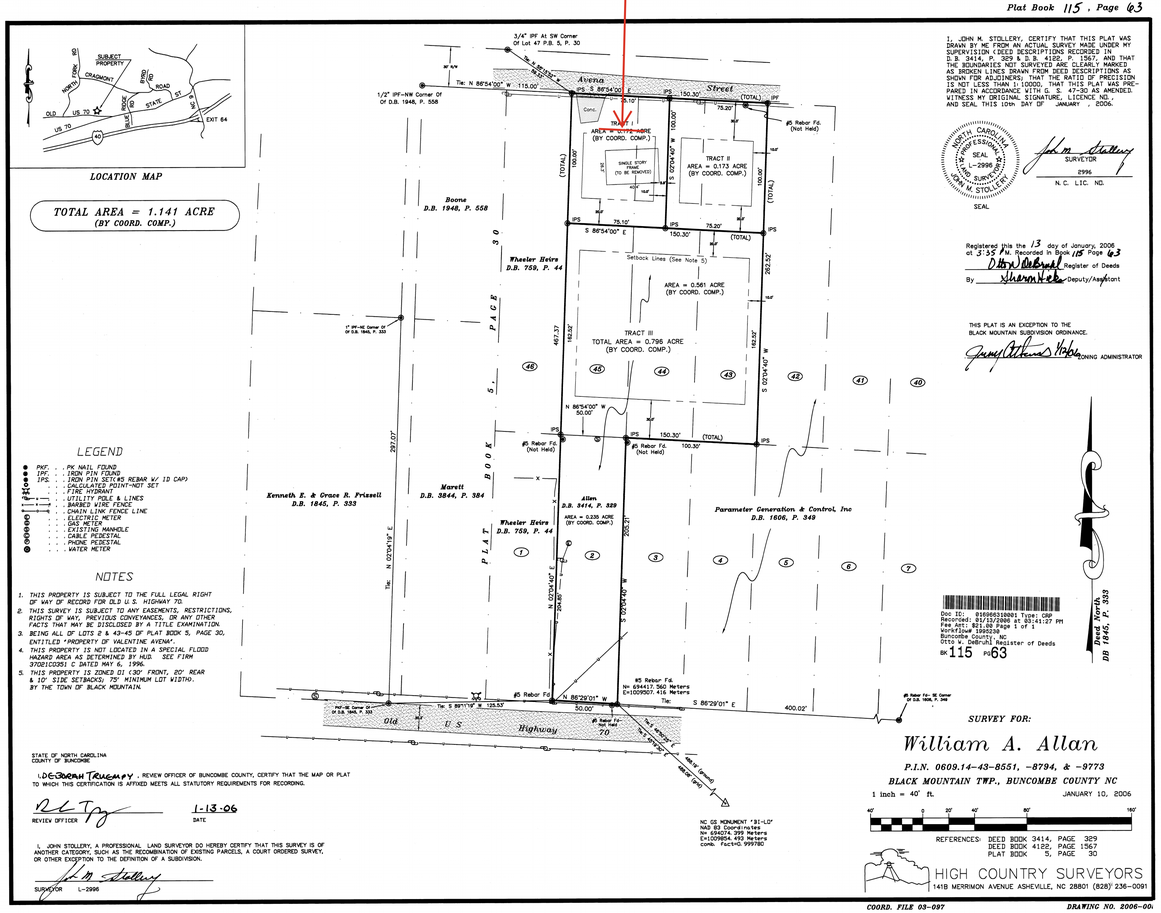

Max & Brooke Cherry Propery Survey from 2006

DRAWINGS PROVIDED BY:
Semper Fi
Tamara Stilwell
Designer
tamara.stilwell@sfcustomremodeling.com


Max & Brooke Cherry
15 Avena St.
Black Mountain, NC 28711

Site Plan

DATE:
5/29/2025

SCALE:
1/4"= 1'

SHEET:
2

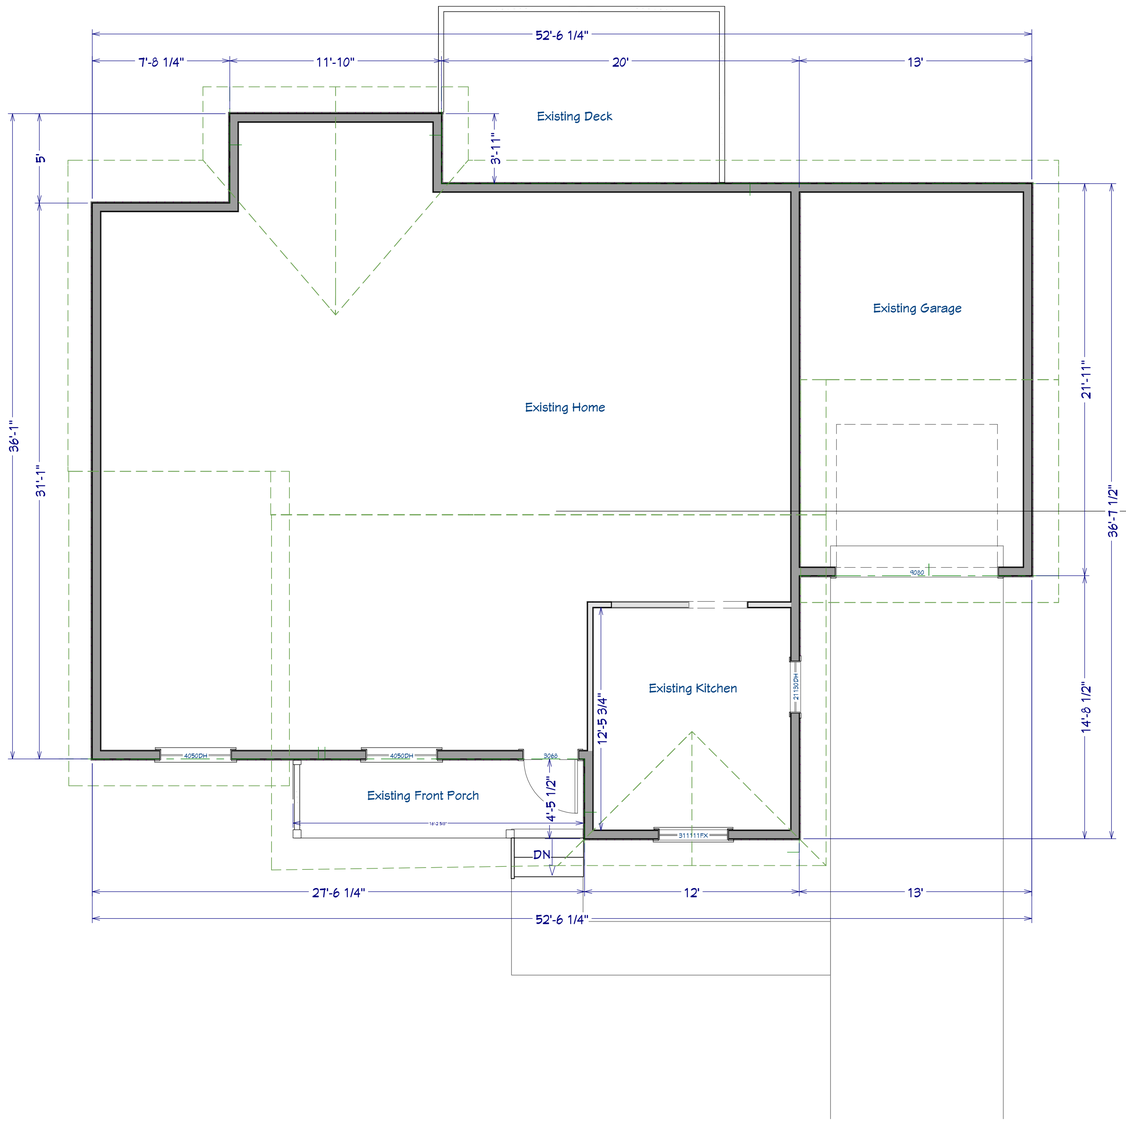

DRAWINGS PROVIDED BY:
Semper Fi
Tamara Stilwell
Designer
tamara.stilwell@sfcustomremodeling.com


Max & Brooke Cherry
15 Avena St.
Black Mountain, NC 28711

As Built -Existing Floor Plan

DATE:
5/29/2025


SCALE:
1/4"= 1'

SHEET:
3

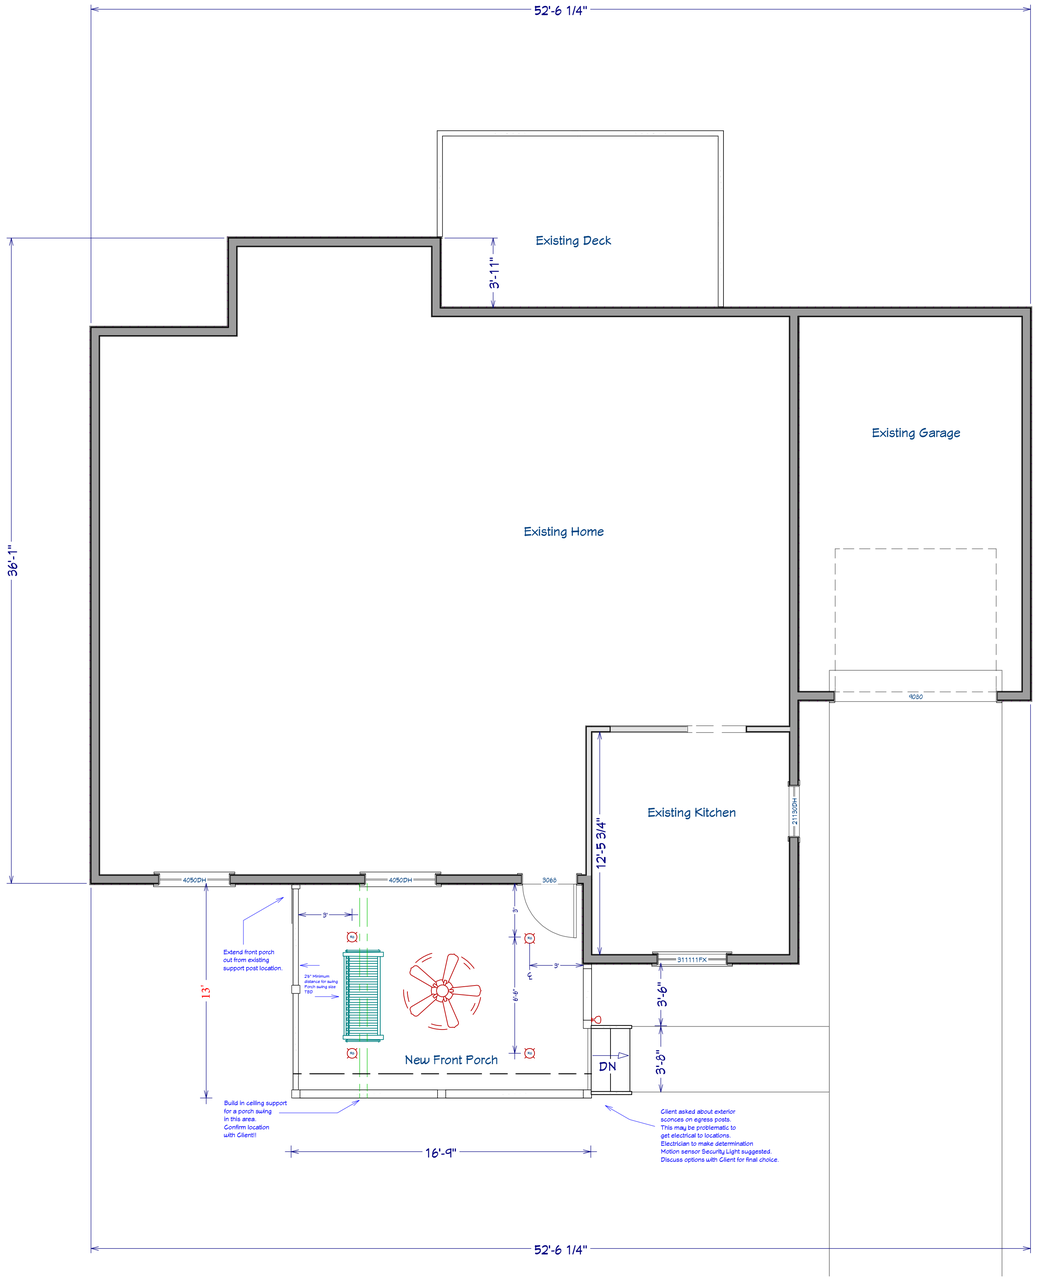

Front Porch New Floor Plan

Electrical Switching Notes

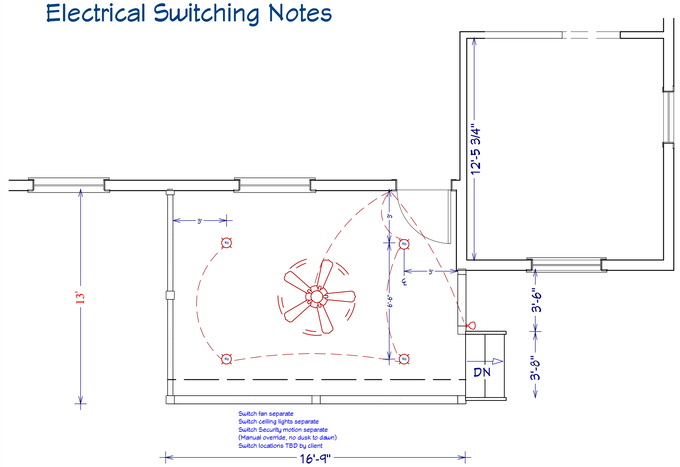

DRAWINGS PROVIDED BY:
Semper Fi
Tamara Stillwell
Designer
tamara.stillwell@sfcustomremodeling.com

Max & Brooke Cherry
15 Avena St.
Black Mountain, NC 28711

New Floor Plan

DATE:
5/29/2025

SCALE:
1/4"= 1'

SHEET:
4