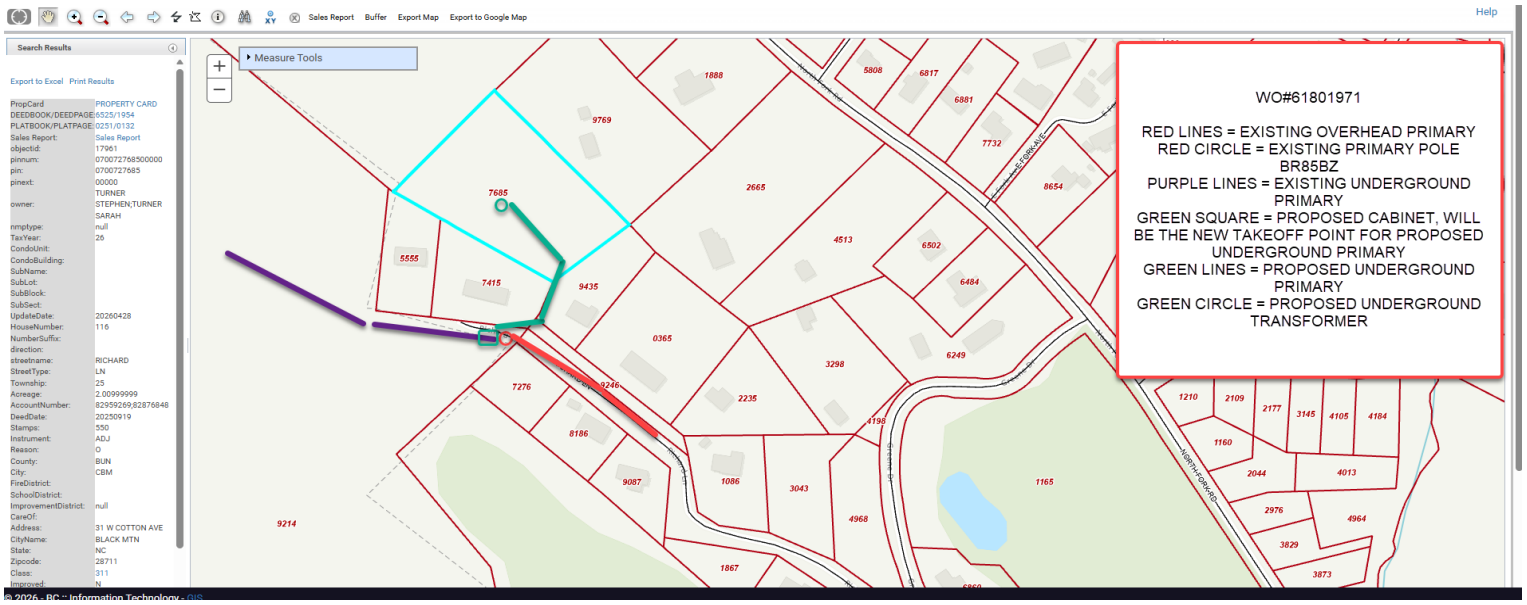

Sales Report
Buffer
Export Map
Export to Google Map
Help
Search Results
Export to Excel
Print Results
Measure Tools
WO#61801971
RED LINES = EXISTING OVERHEAD PRIMARY
RED CIRCLE = EXISTING PRIMARY POLE BR85BZ
PURPLE LINES = EXISTING UNDERGROUND PRIMARY
GREEN SQUARE = PROPOSED CABINET, WILL BE THE NEW TAKEOFF POINT FOR PROPOSED UNDERGROUND PRIMARY
GREEN LINES = PROPOSED UNDERGROUND PRIMARY
GREEN CIRCLE = PROPOSED UNDERGROUND TRANSFORMER
© 2026 - BC :: Information Technology - GIS